

Lower Level Floor Plan



Grant Monument Association
As Built Floor Plans
Grant's Tomb
New York, NY

ASSI
ARCHITECTURAL SUPPORT SERVICES, INC.
C.A.D. SERVICES
377 Richardson Road, SE
Suite 1
Cathoun, GA 30701
Phone: 770.866.6156
Fax: 770.888.9664
assi-cad.com

VIC WILLIAMS - PRESIDENT A.S.S.I.


REYNOLDS
architects
Reynolds Architects, P.C.
315 Academy Street, NE
Gainesville, Georgia 30501
M. Garland Reynolds, Jr. - FAIA, NCARB
Office: (770) 531-0100 Cell: (770) 530-8017
Fax: (770) 531-7956 e-mail: Reyarch@mindspring.com
http://garlandreynoldsarchitect.com

DRAWING NAME	
Lower Level Floor Plan	
SCALE	PROJECT NO.
3/16"=1'-0"	-
DRAWN BY	DATE
A S S I	05.02.17
DRAWING NO.	

The scales as stated herein are valid on the original drawing. These scales are hereby changed by the ratio of the overall sheet dimensions of the print to corresponding dimensions of the original drawing.


The drawing is the property of REYNOLDS ARCHITECTS, P.C. and is not to be copied or reproduced in whole or part. It is specifically identified herein and is not to be used on any other project. It is to be returned upon request.

Copyrighted © 2017 Reynolds Architects, P.C. / Vic Williams

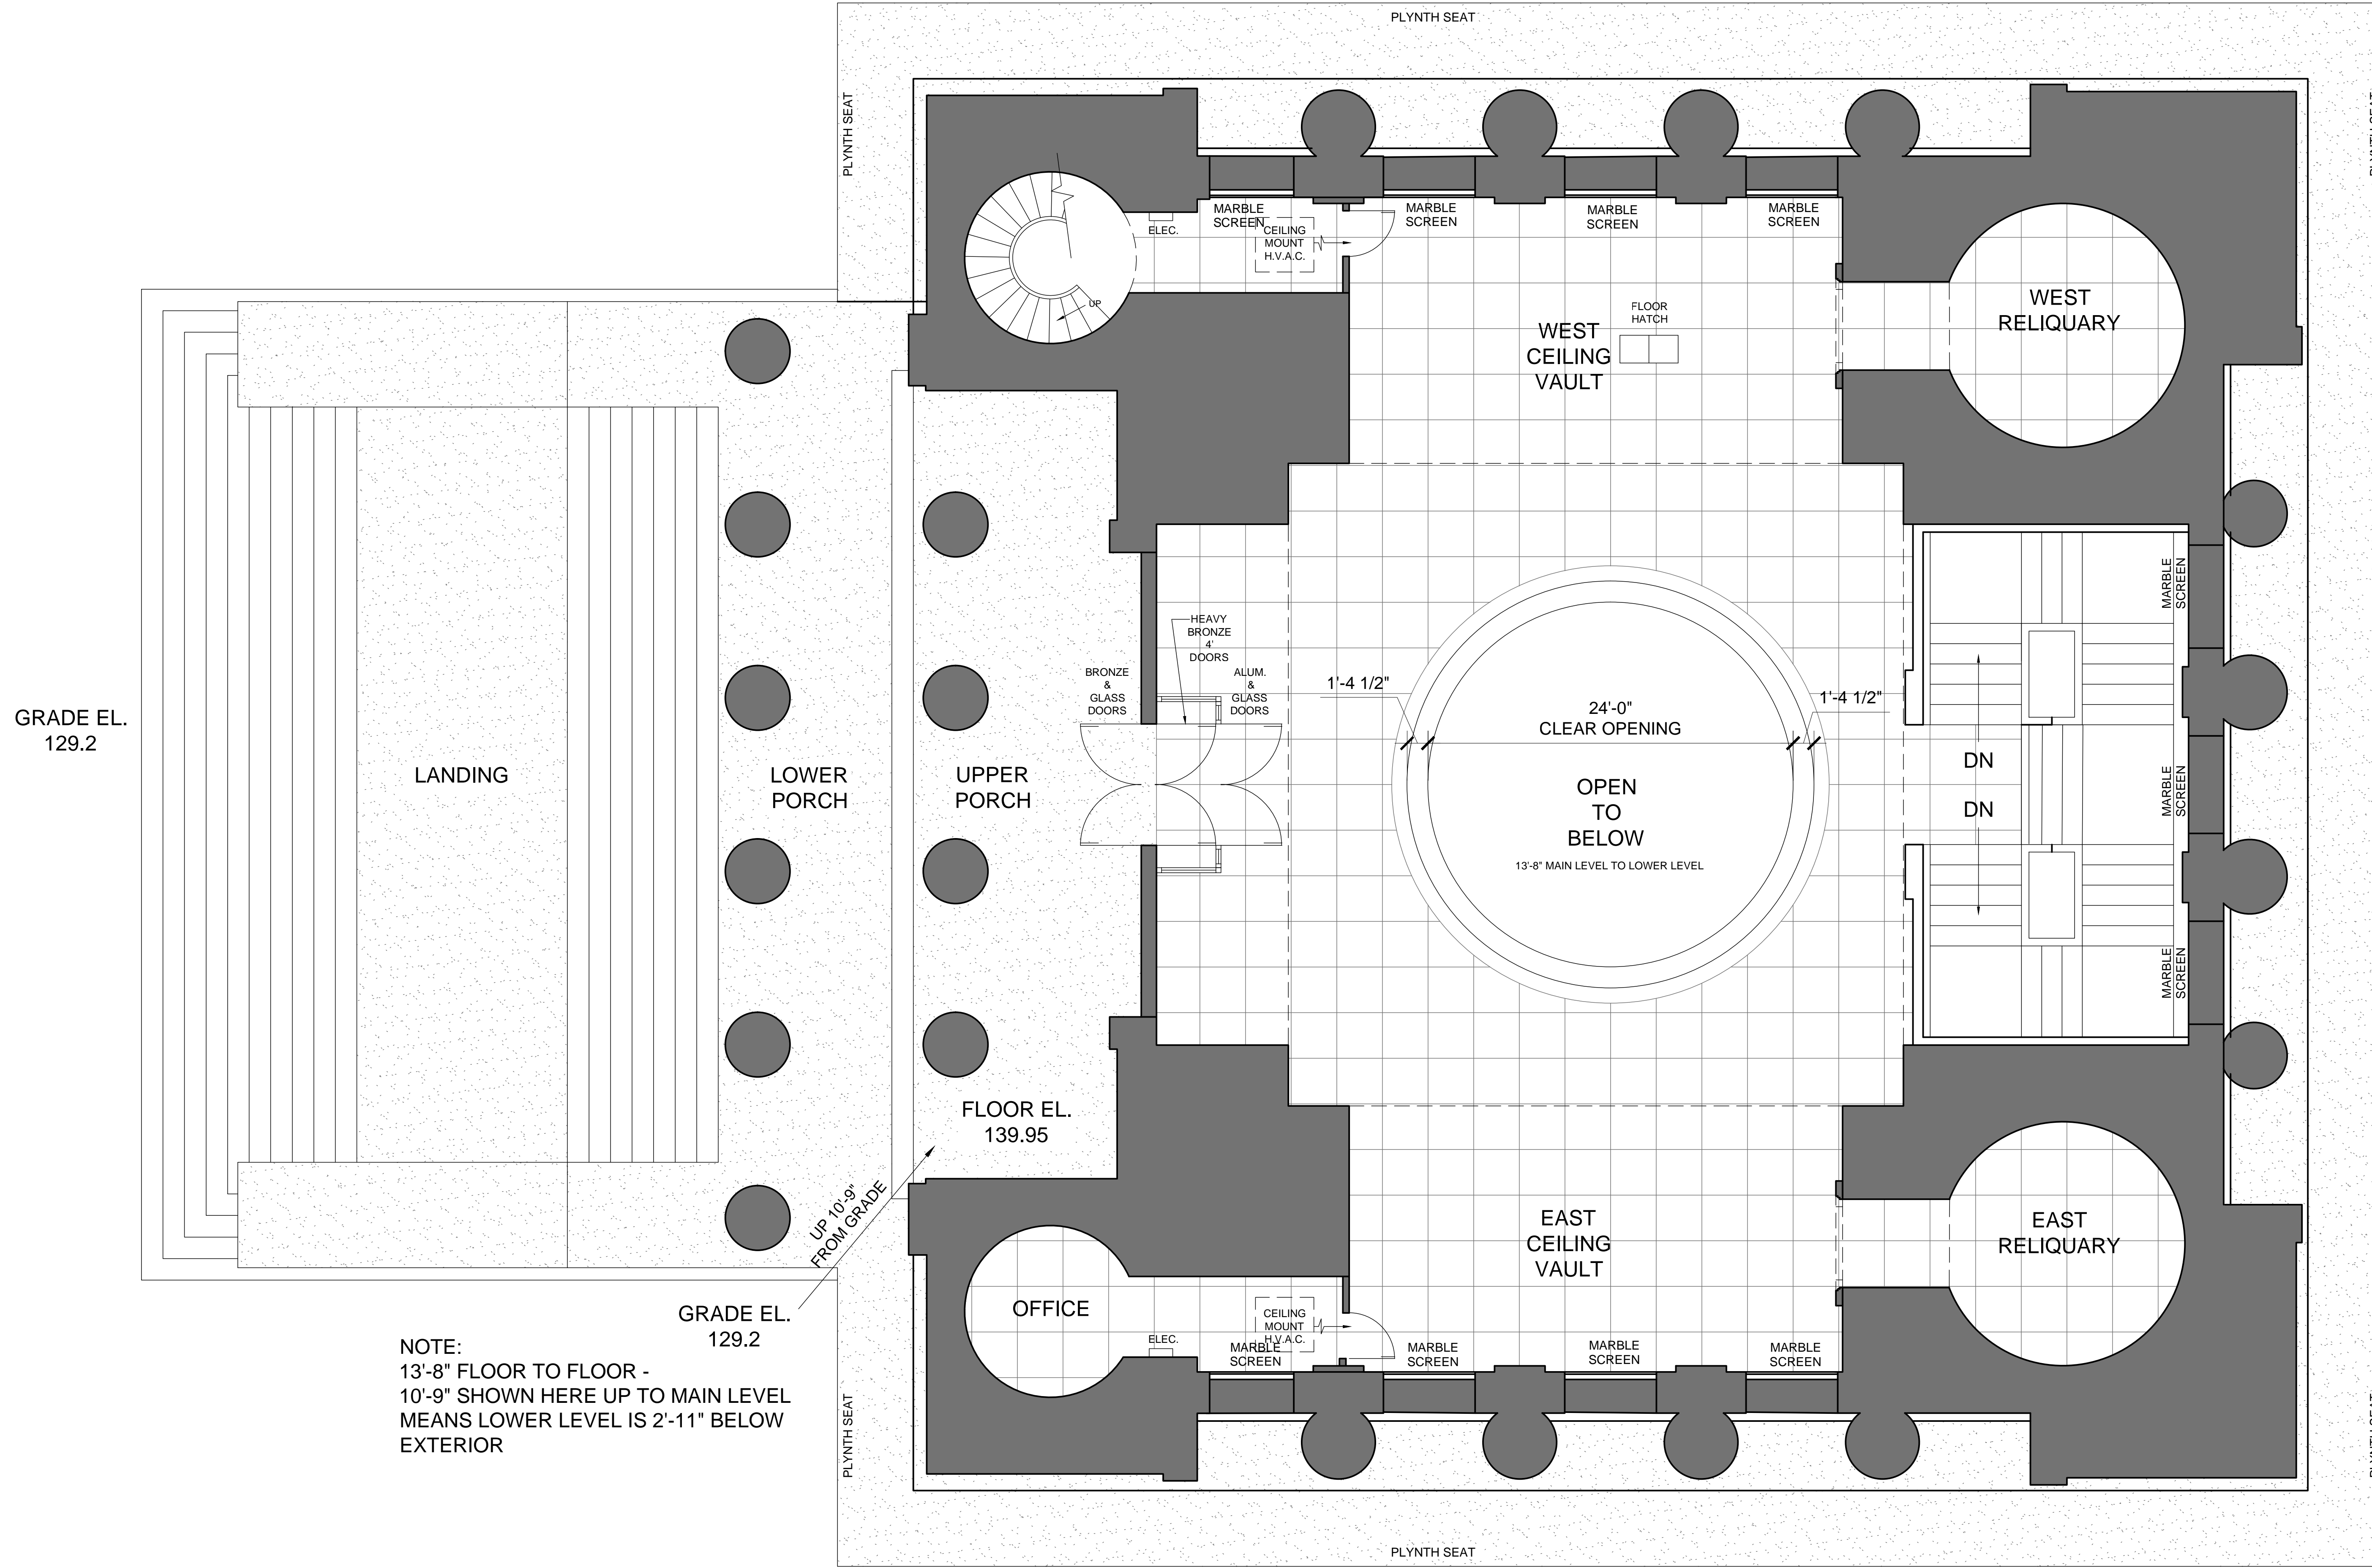

NOTE:
13'-8" FLOOR TO FLOOR -
10'-9" SHOWN HERE UP TO MAIN LEVEL
MEANS LOWER LEVEL IS 2'-11" BELOW
EXTERIOR

Main Level Floor Plan

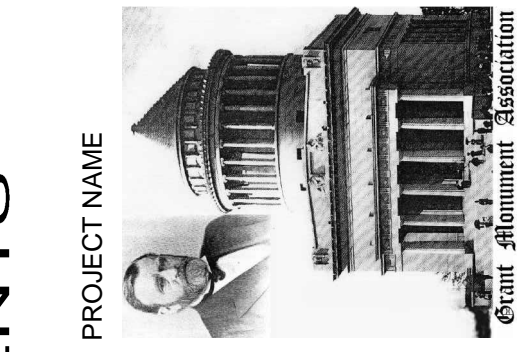

PROJECT NAME	Grant Monument Restoration
DRAWING NAME	Main Level Floor Plan
SCALE	3/16" = 1'-0"
DRAWN BY	A S S I
DRAWING NO.	
PROJECT NO.	
DATE	05.02.17

A1

LAS BUILT DOCUMENTS

Grant Monument Association
As Built Floor Plans
Grant's Tomb
New York, NY

ASSI
ARCHITECTURAL SUPPORT SERVICES
C.A.D. SERVICES
377 Richardson Road, SE
Suite 1
Cathoun, GA 30701
Phone: 770.866.6156
Fax: 770.888.9664
assi-cad.com

VIC WILLIAMS - PRESIDENT A.S.S.I.

REYNOLDS
architects

Reynolds Architects, P.C.
315 Academy Street, NE
Gainesville, Georgia 30501
M. Garland Reynolds, Jr. - FAIA, NCARB
Office: (770) 531-0100 Cell: (770) 590-8017
Fax: (770) 531-7956 e-mail: Reyarch@mindspring.com
http://garlandreynoldsarchitect.com